



# SEPTIC DESIGNS: NOT ALL THE SAME

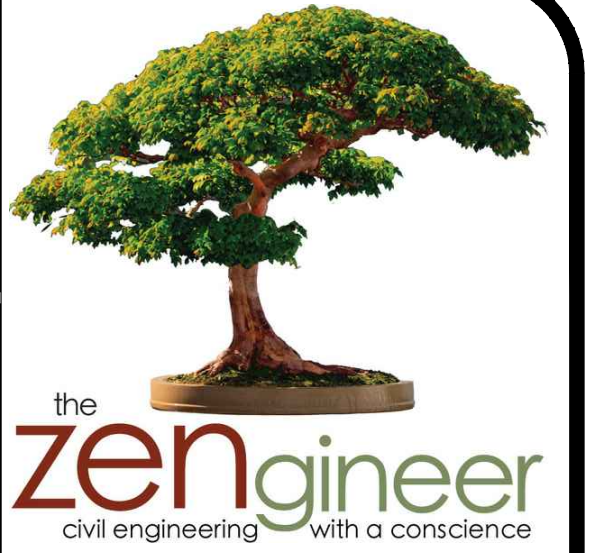

## ORIGINAL DESIGN

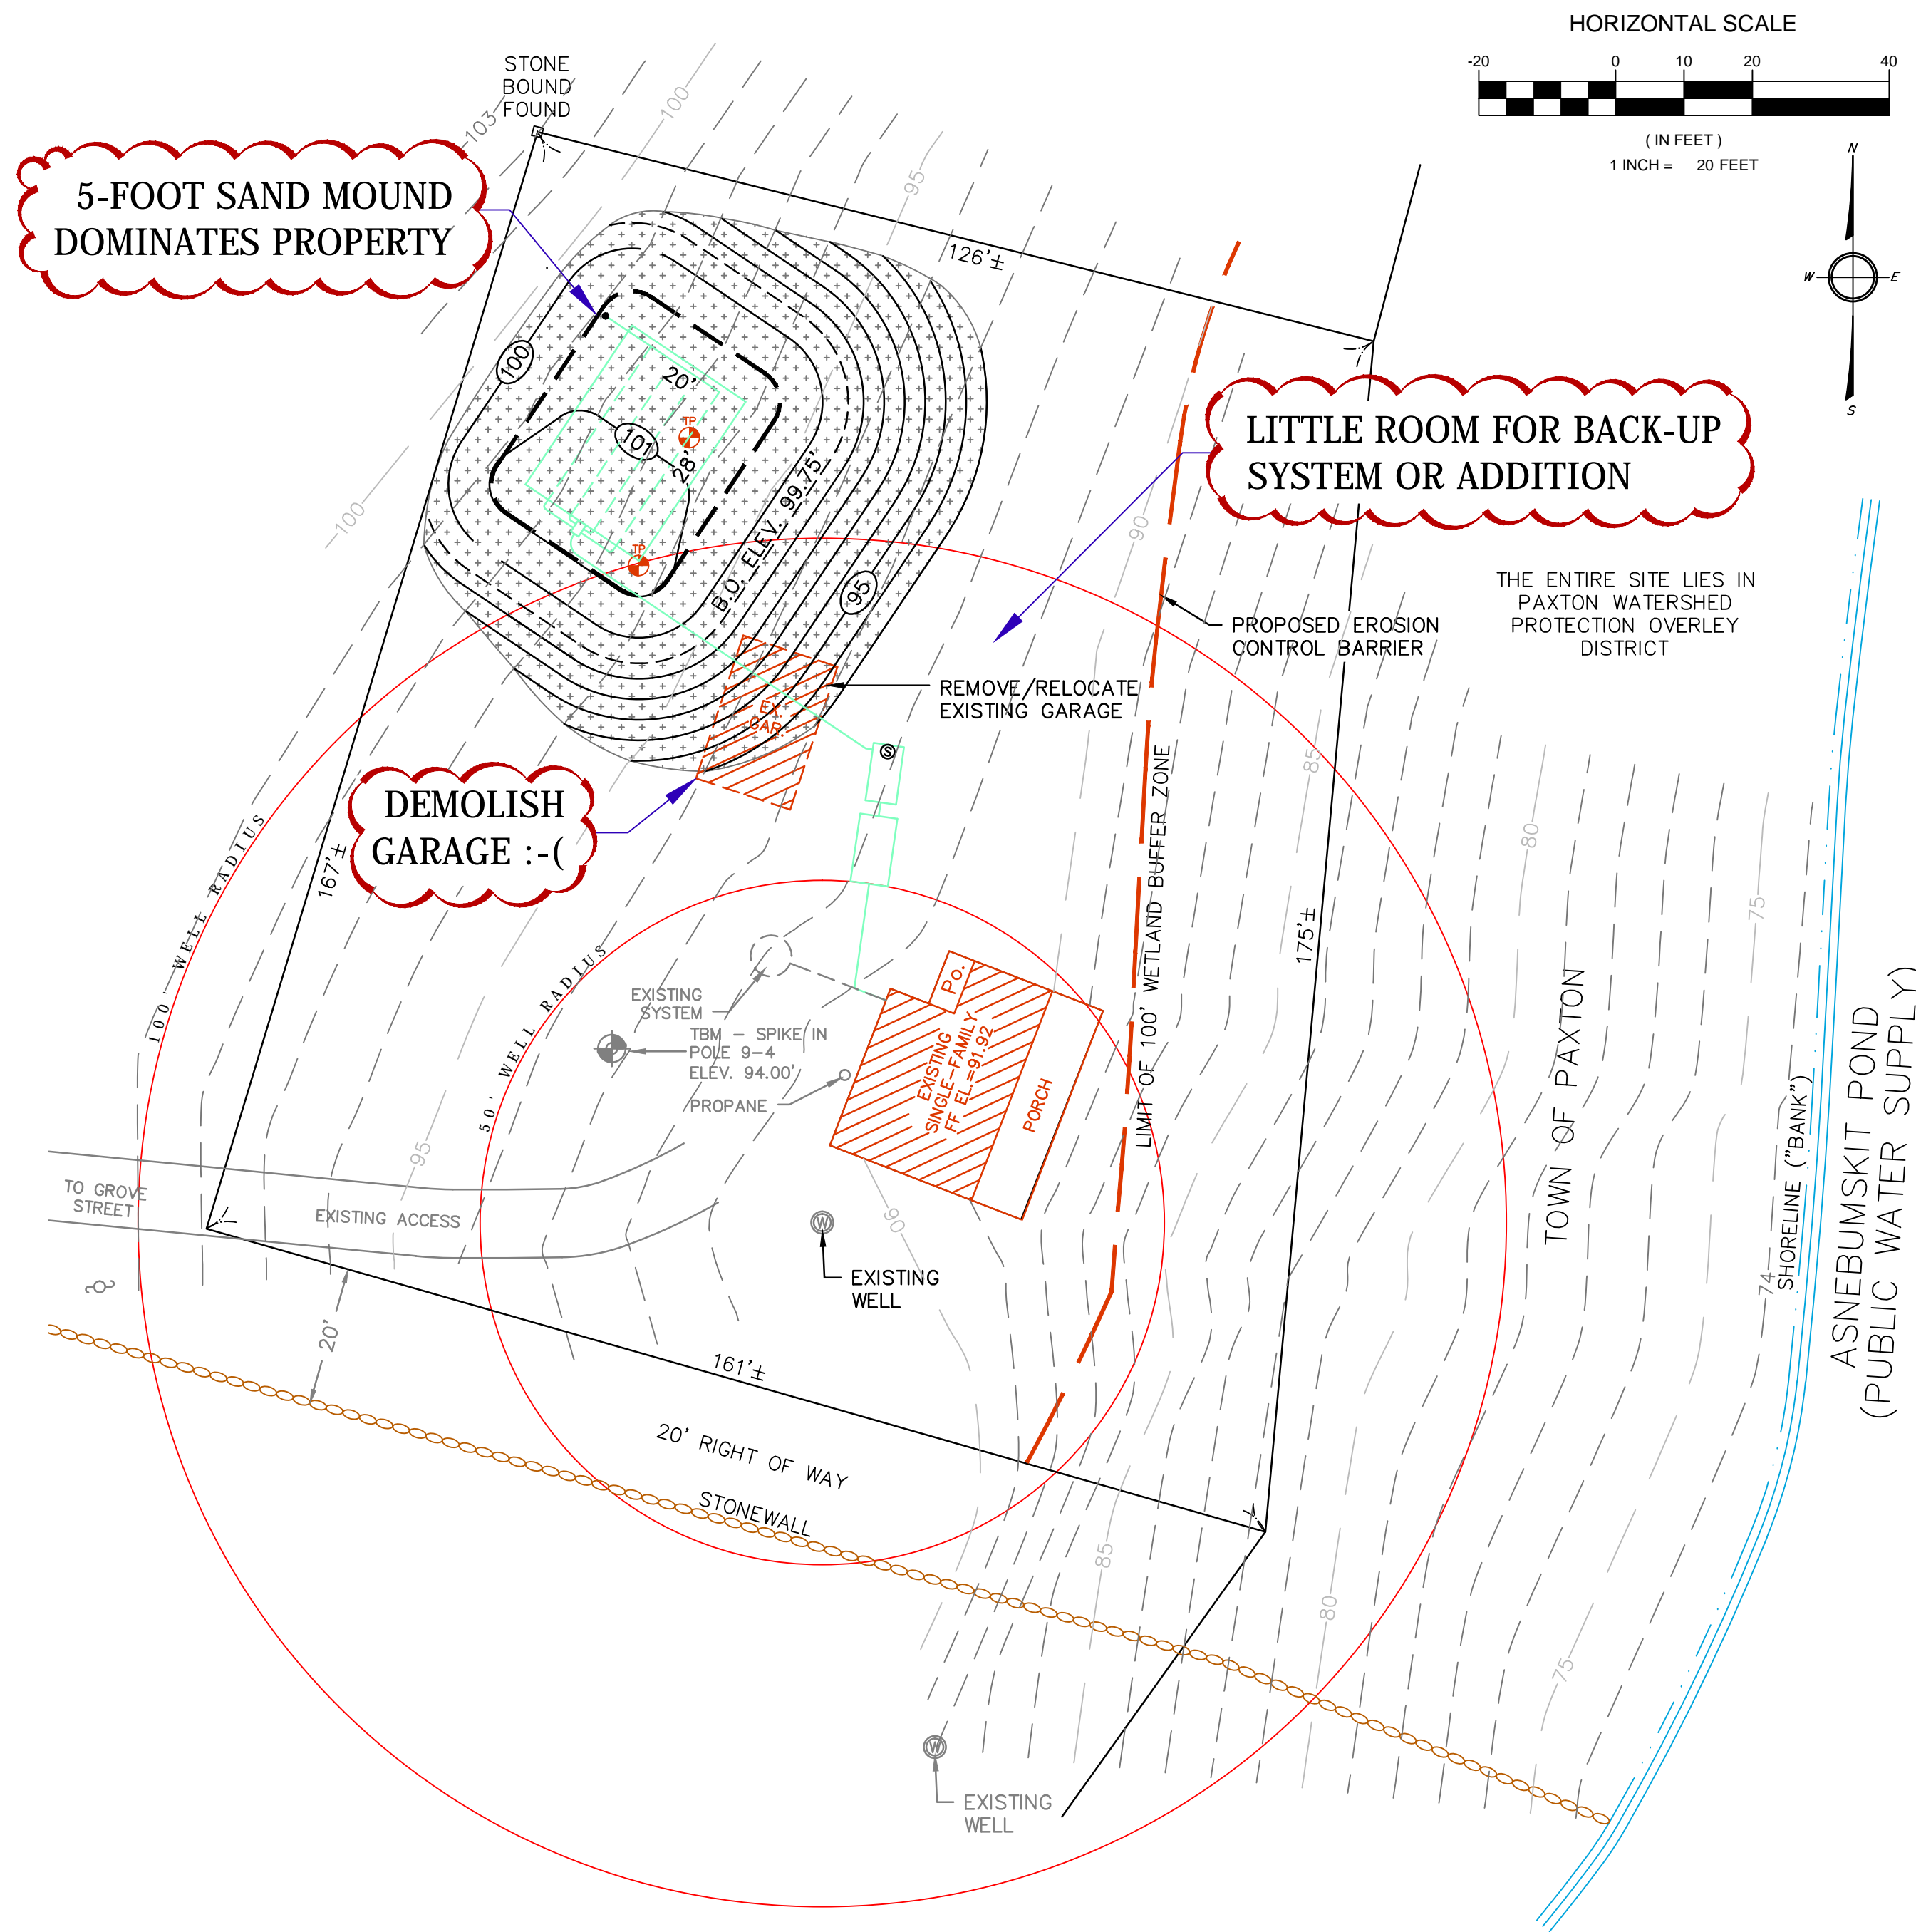

### PROS

1. Path of least resistance.
2. Fastest to design.
3. Met minimum health standards.

### CONS

1. Demolition of existing garage required.
2. Five foot tall, 5000 SF mound of sand.
3. Minimal drinking water protection.
4. Little room for back-up system.
5. Little room for future addition.
6. Expensive to build.

## ZENGINEER DESIGN



### PROS

1. Saved existing building.
2. Superior drinking water protection.
3. Level with ground, minimal disturbance.
4. Exceeds minimum health standards.
5. Adequate room for back-up system.
6. Adequate room for future addition.
7. Thousands saved in construction costs.

### CONS

1. More advanced design required.

**PREPARED BY:**  
THE ZENGINEER  
BUCKY SPARKLE, P.E.  
378 MAIN STREET, #2  
EASTHAMPTON, MA 01027  
www.theZengineer.com  
zengineerbucky@gmail.com  
(617) 271-4004

**PREPARED FOR:**  
PRIVATE CLIENT  
PAXTON, MA

**PROJECT:**  
SUBSURFACE SEWAGE  
DISPOSAL SYSTEM

PROJECT No.: N/A  
FILE NAME: Maddy Plan 2014.01.dwg

No.	Revision	Date
1	DEMONSTRATION PLAN	3.14.15

SEPTIC PLAN

SHEET 1 OF 1